

금원산 자연휴양림 트리하우스

준공도면

2021.10.15


부산대학교 실내환경디자인학과

201761709 박성희

201761728 허성은

목 차

DRAWING NO.	DRAWING TITLE	SCALE
1	자연휴양림 로비 평면도	A1: 1/150 A3: 1/300
2	2인실 트리하우스 평면도 4인실 트리하우스 평면도	A1: 1/250 A3: 1/500
3	8인실 트리하우스 평면도	A1: 1/250 A3: 1/500
4	자연휴양림 로비 단면도	A1: 1/250 A3: 1/500
5	자연휴양림 로비 천장도	A1: 1/150 A3: 1/300
6	2인실 트리하우스 천장도 4인실 트리하우스 천장도	A1: 1/250 A3: 1/500
7	8인실 트리하우스 천장도	A1: 1/250 A3: 1/500

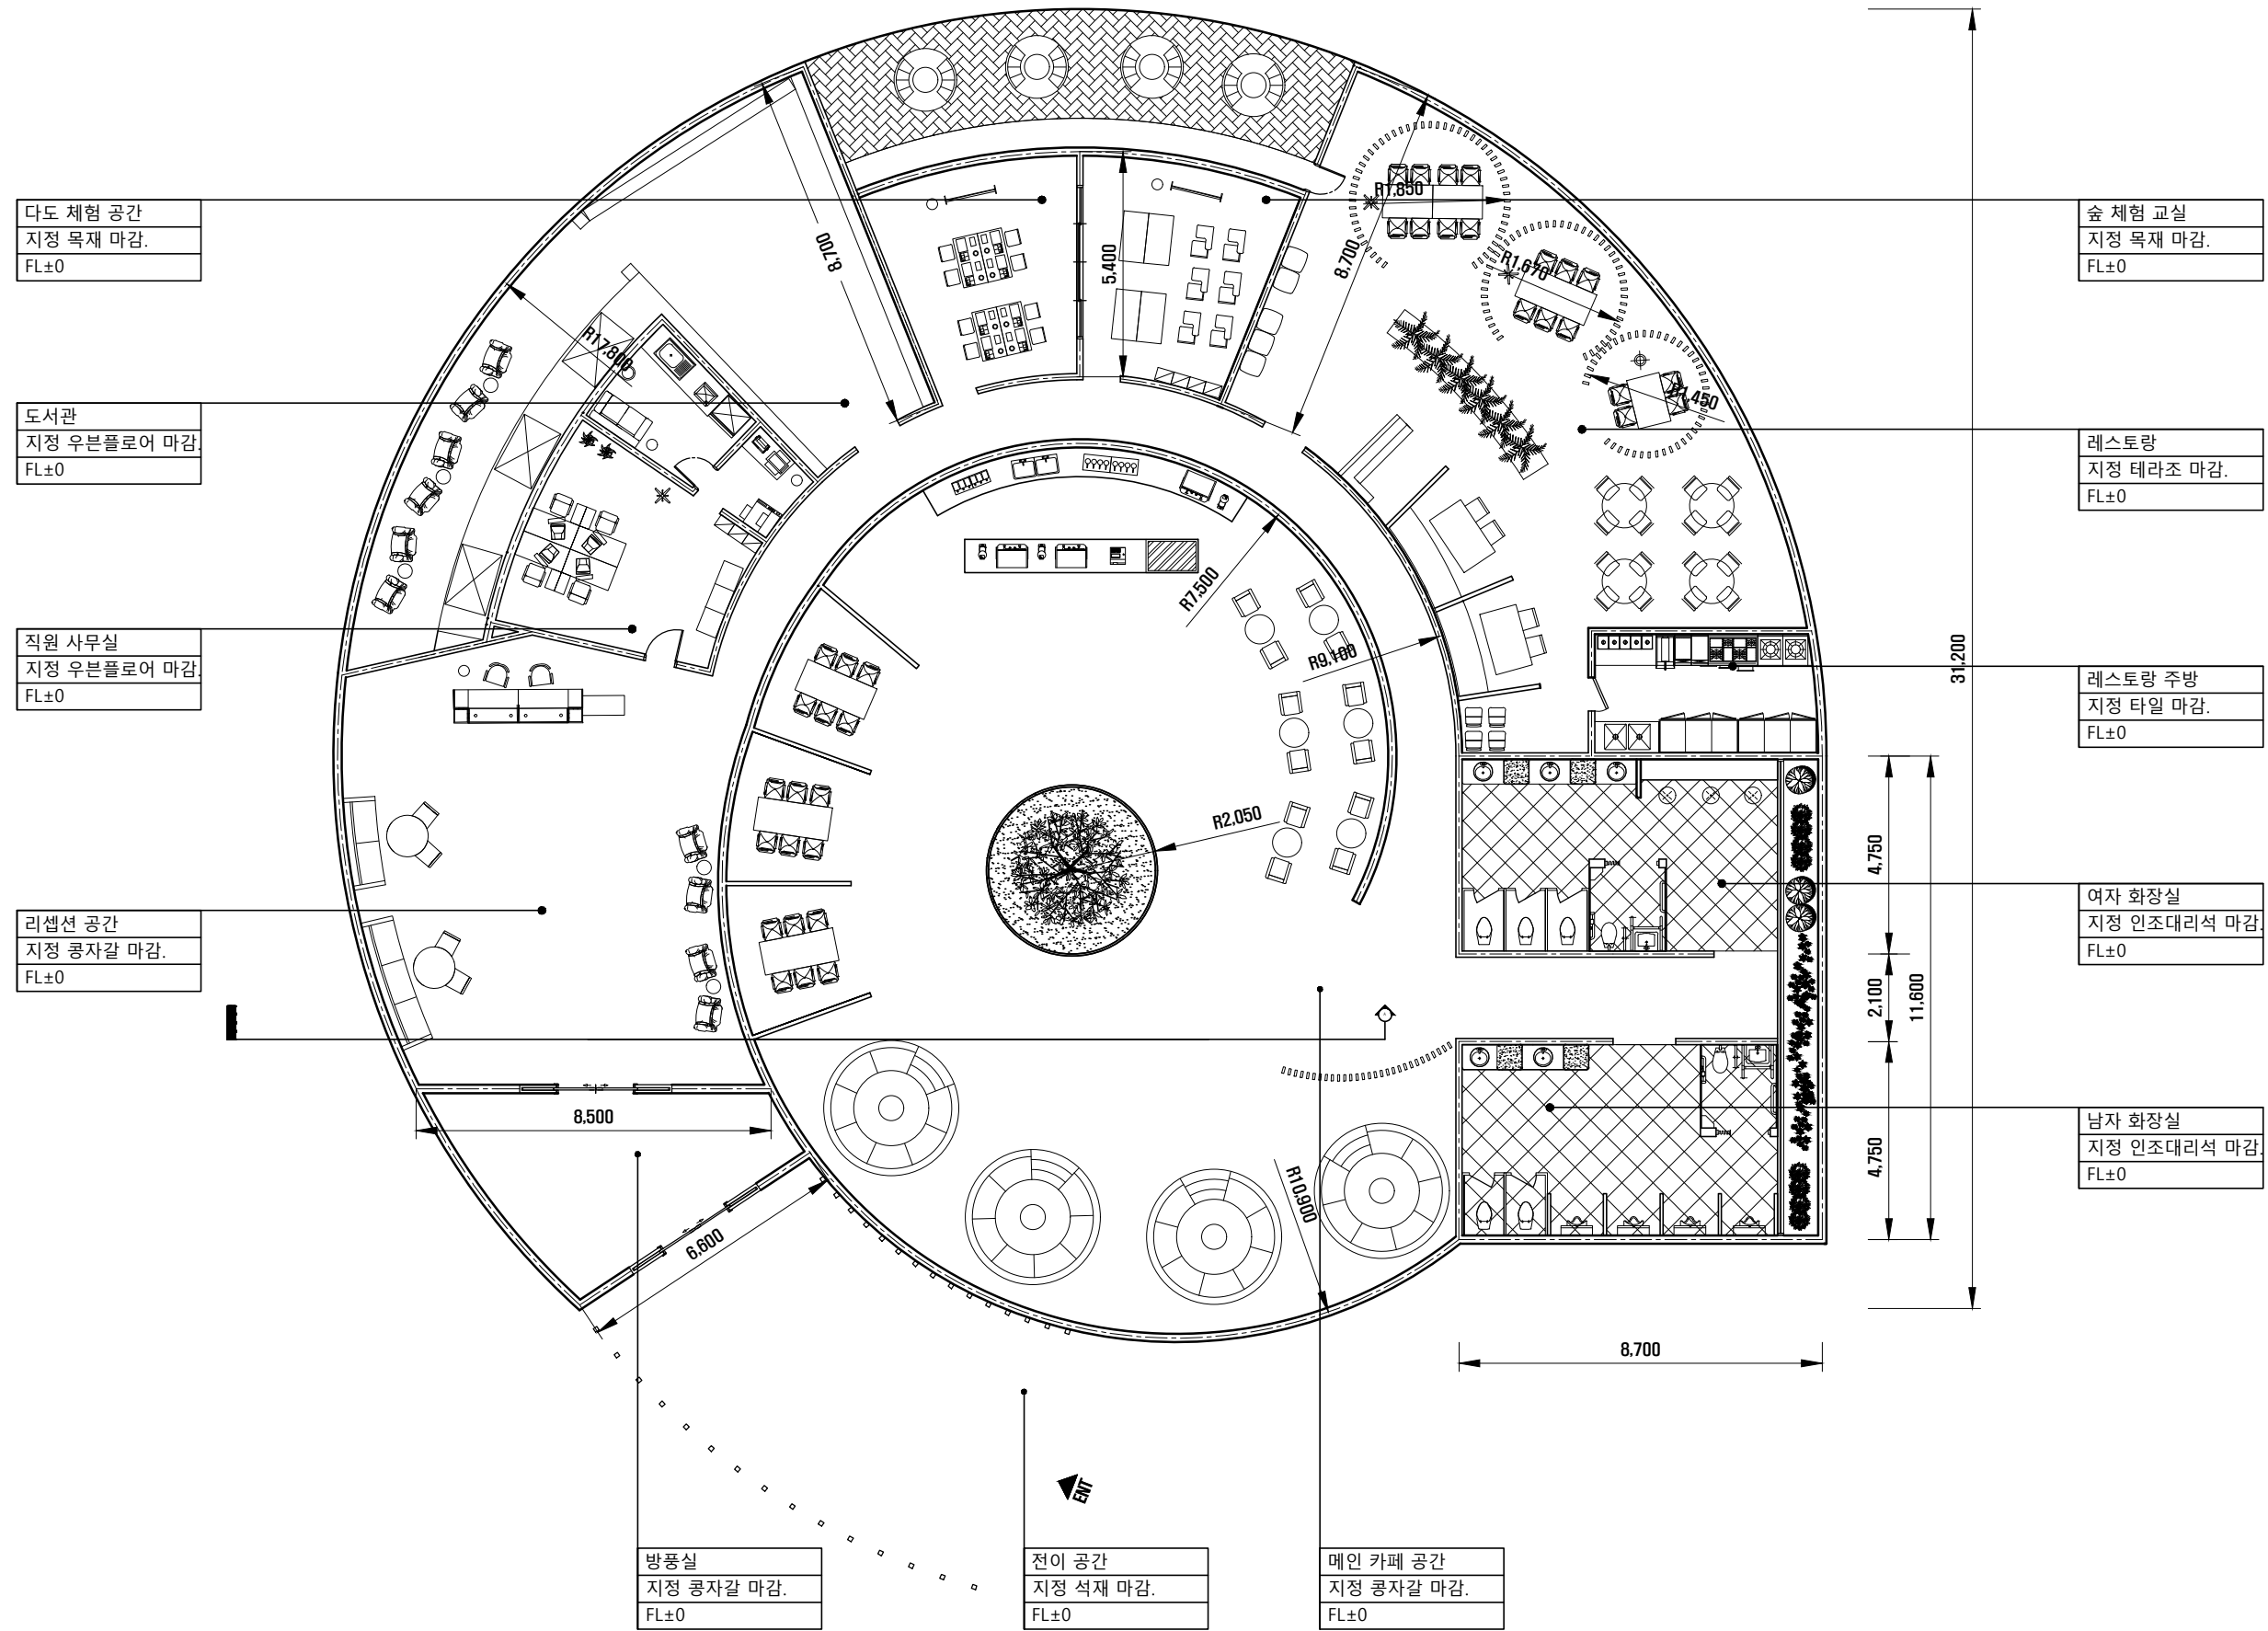

PROJECT TITLE

금원산 자연휴양림

DRAWING TITLE

LOBBY FLOOR PLAN

SCALE

A1: 1/150 A3: 1/300

DATE

2021.10.16



APPROVED

201761709 박성희

201761728 허성은

DRAWING NO.

1

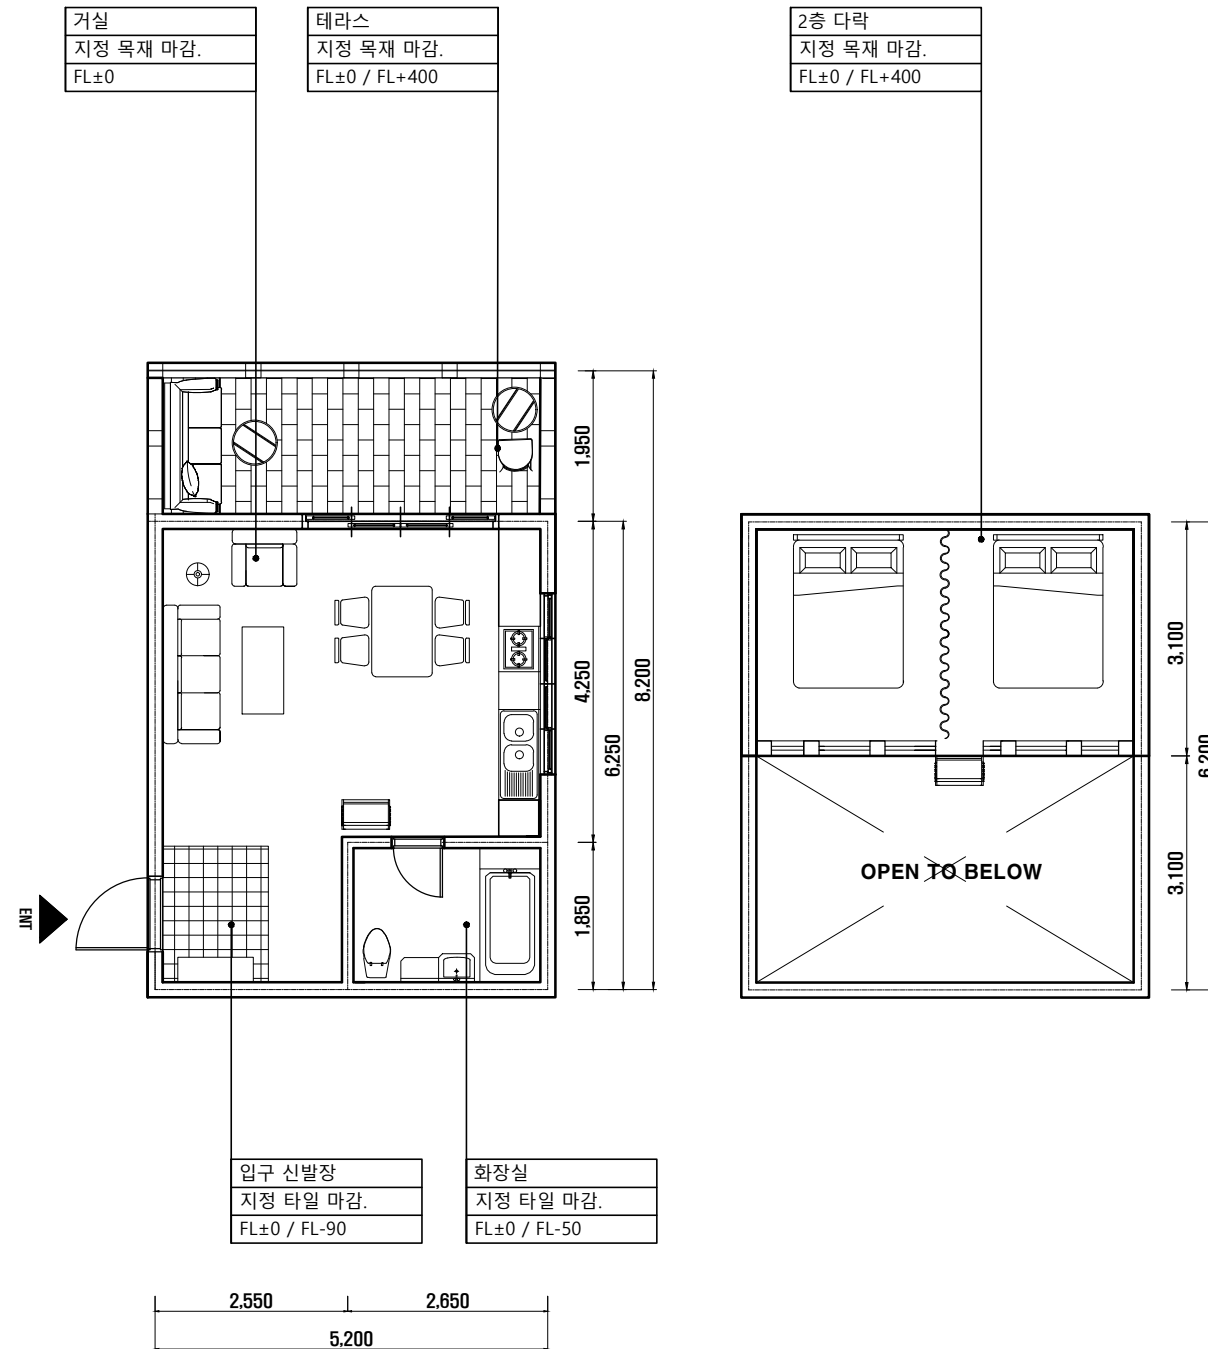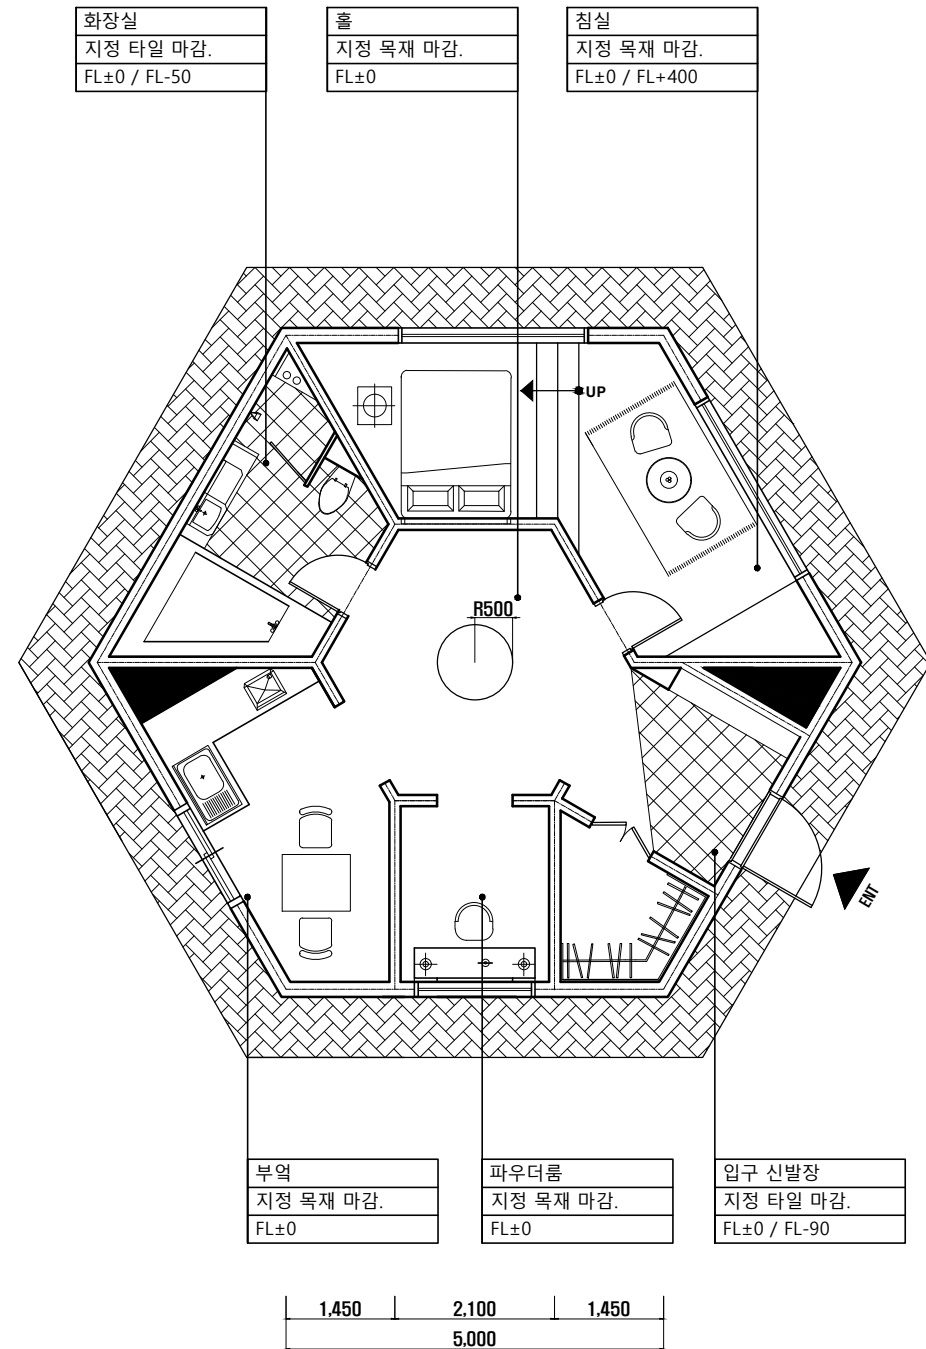

7팀
금원산 자연휴양림

부산대학교
실내환경디자인학과

PROJECT TITLE
금원산 자연휴양림


DRAWING TITLE
2, 4인실 FLOOR PLAN

SCALE
A1: 1/250 A3: 1/500

DATE
2021.10.16

APPROVED
201761709 박성희
201761728 허성은

DRAWING NO.
2

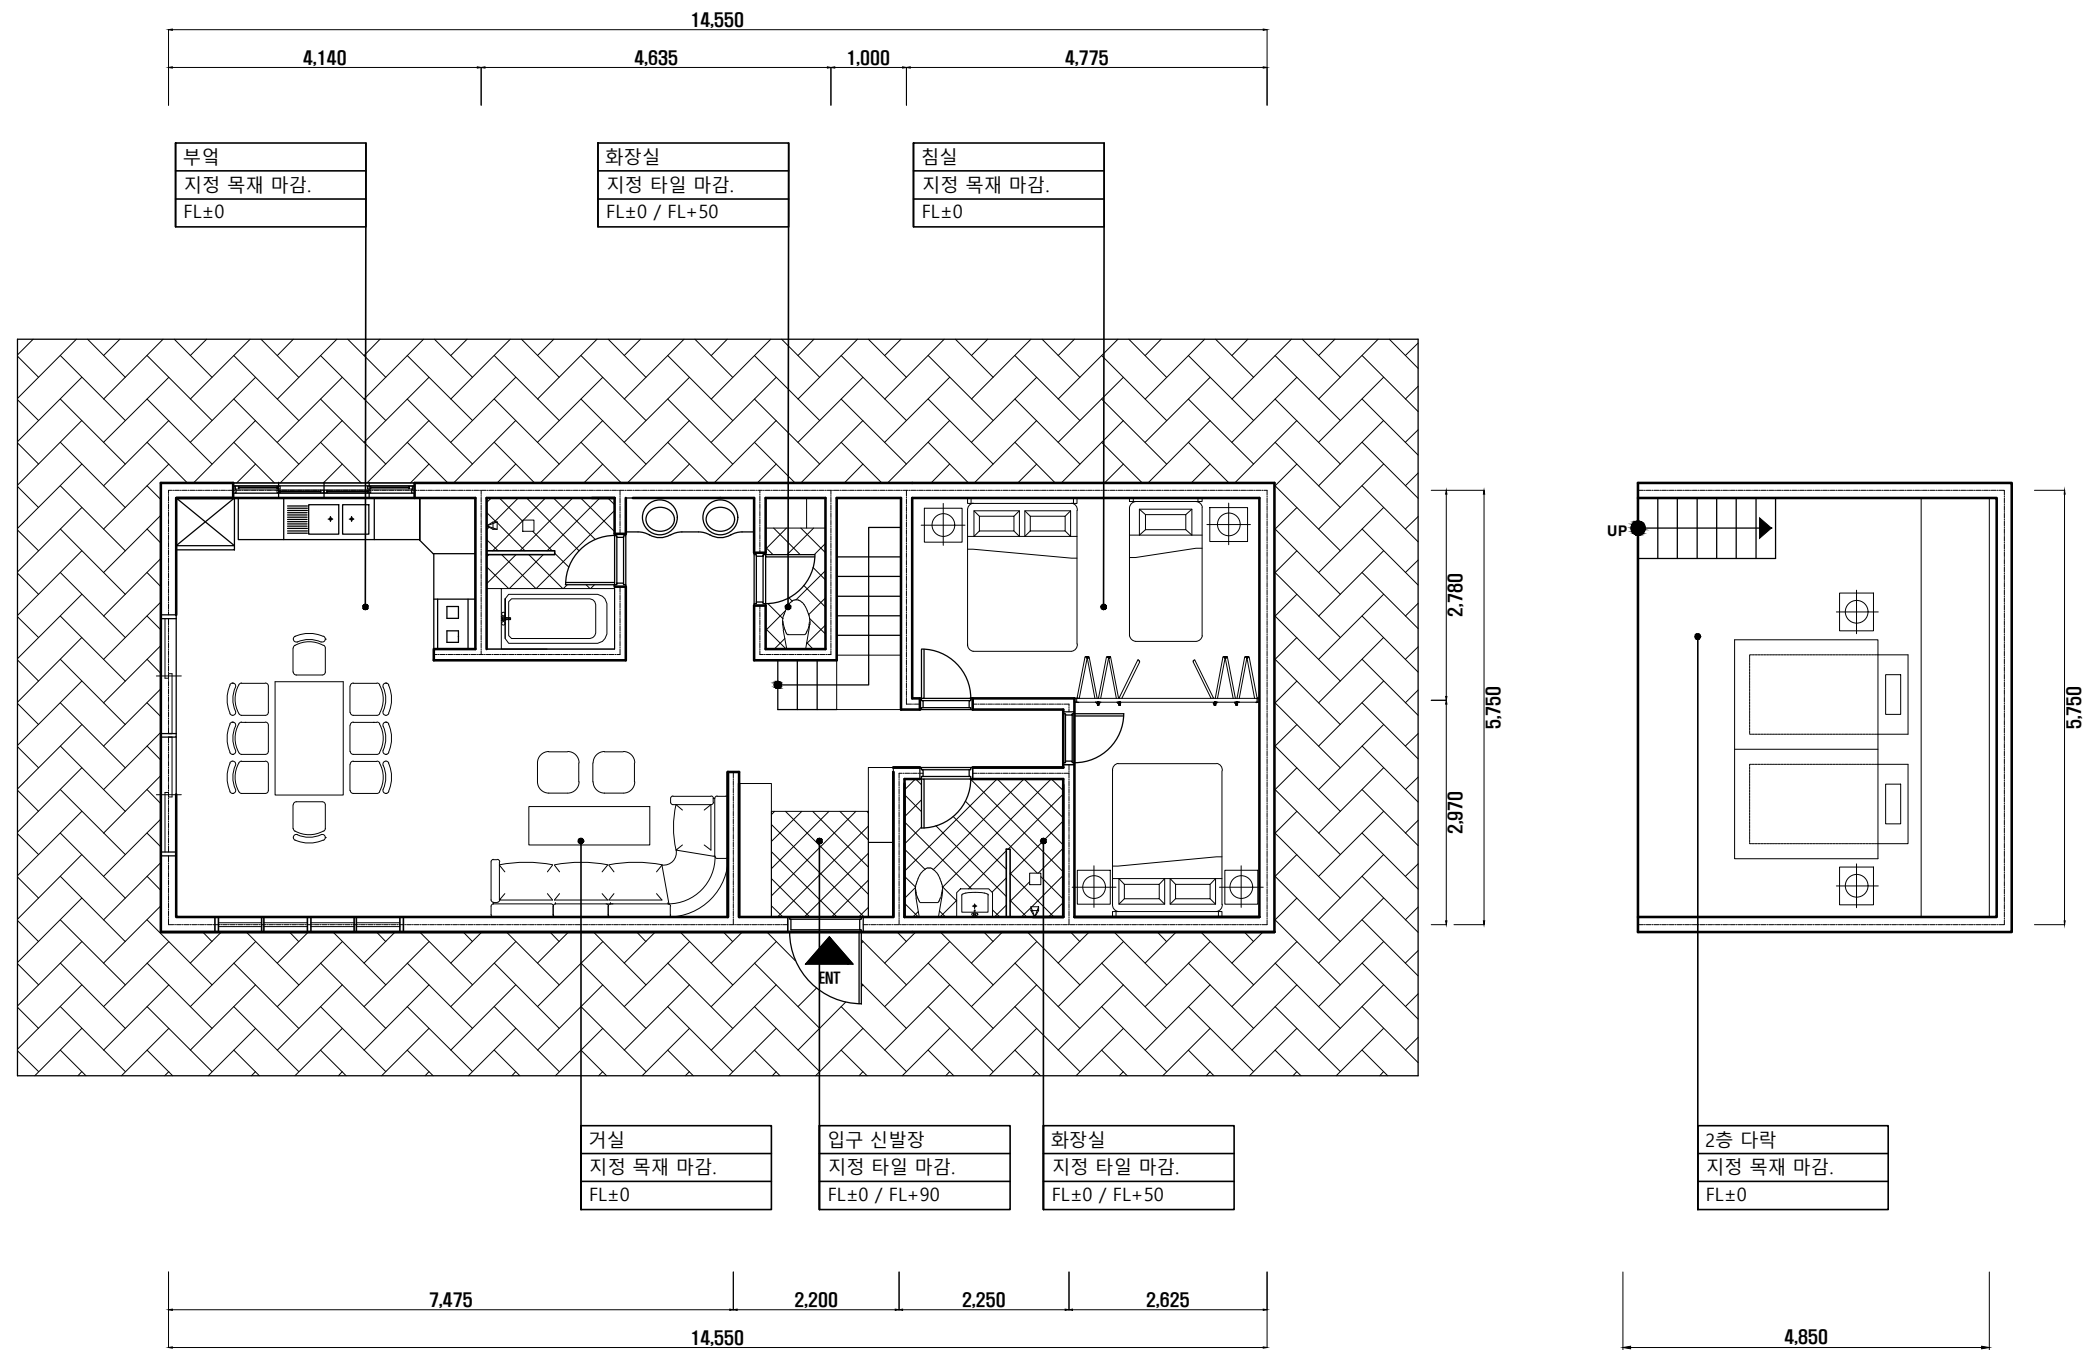

PROJECT TITLE
금원산 자연휴양림

DRAWING TITLE
8인실 FLOOR PLAN

SCALE
A1: 1/250 A3: 1/500


DATE
2021.10.16

APPROVED
201761709 박성희
201761728 허성은

DRAWING NO.

7팀
금원산 자연휴양림

부산대학교
실내환경디자인학과

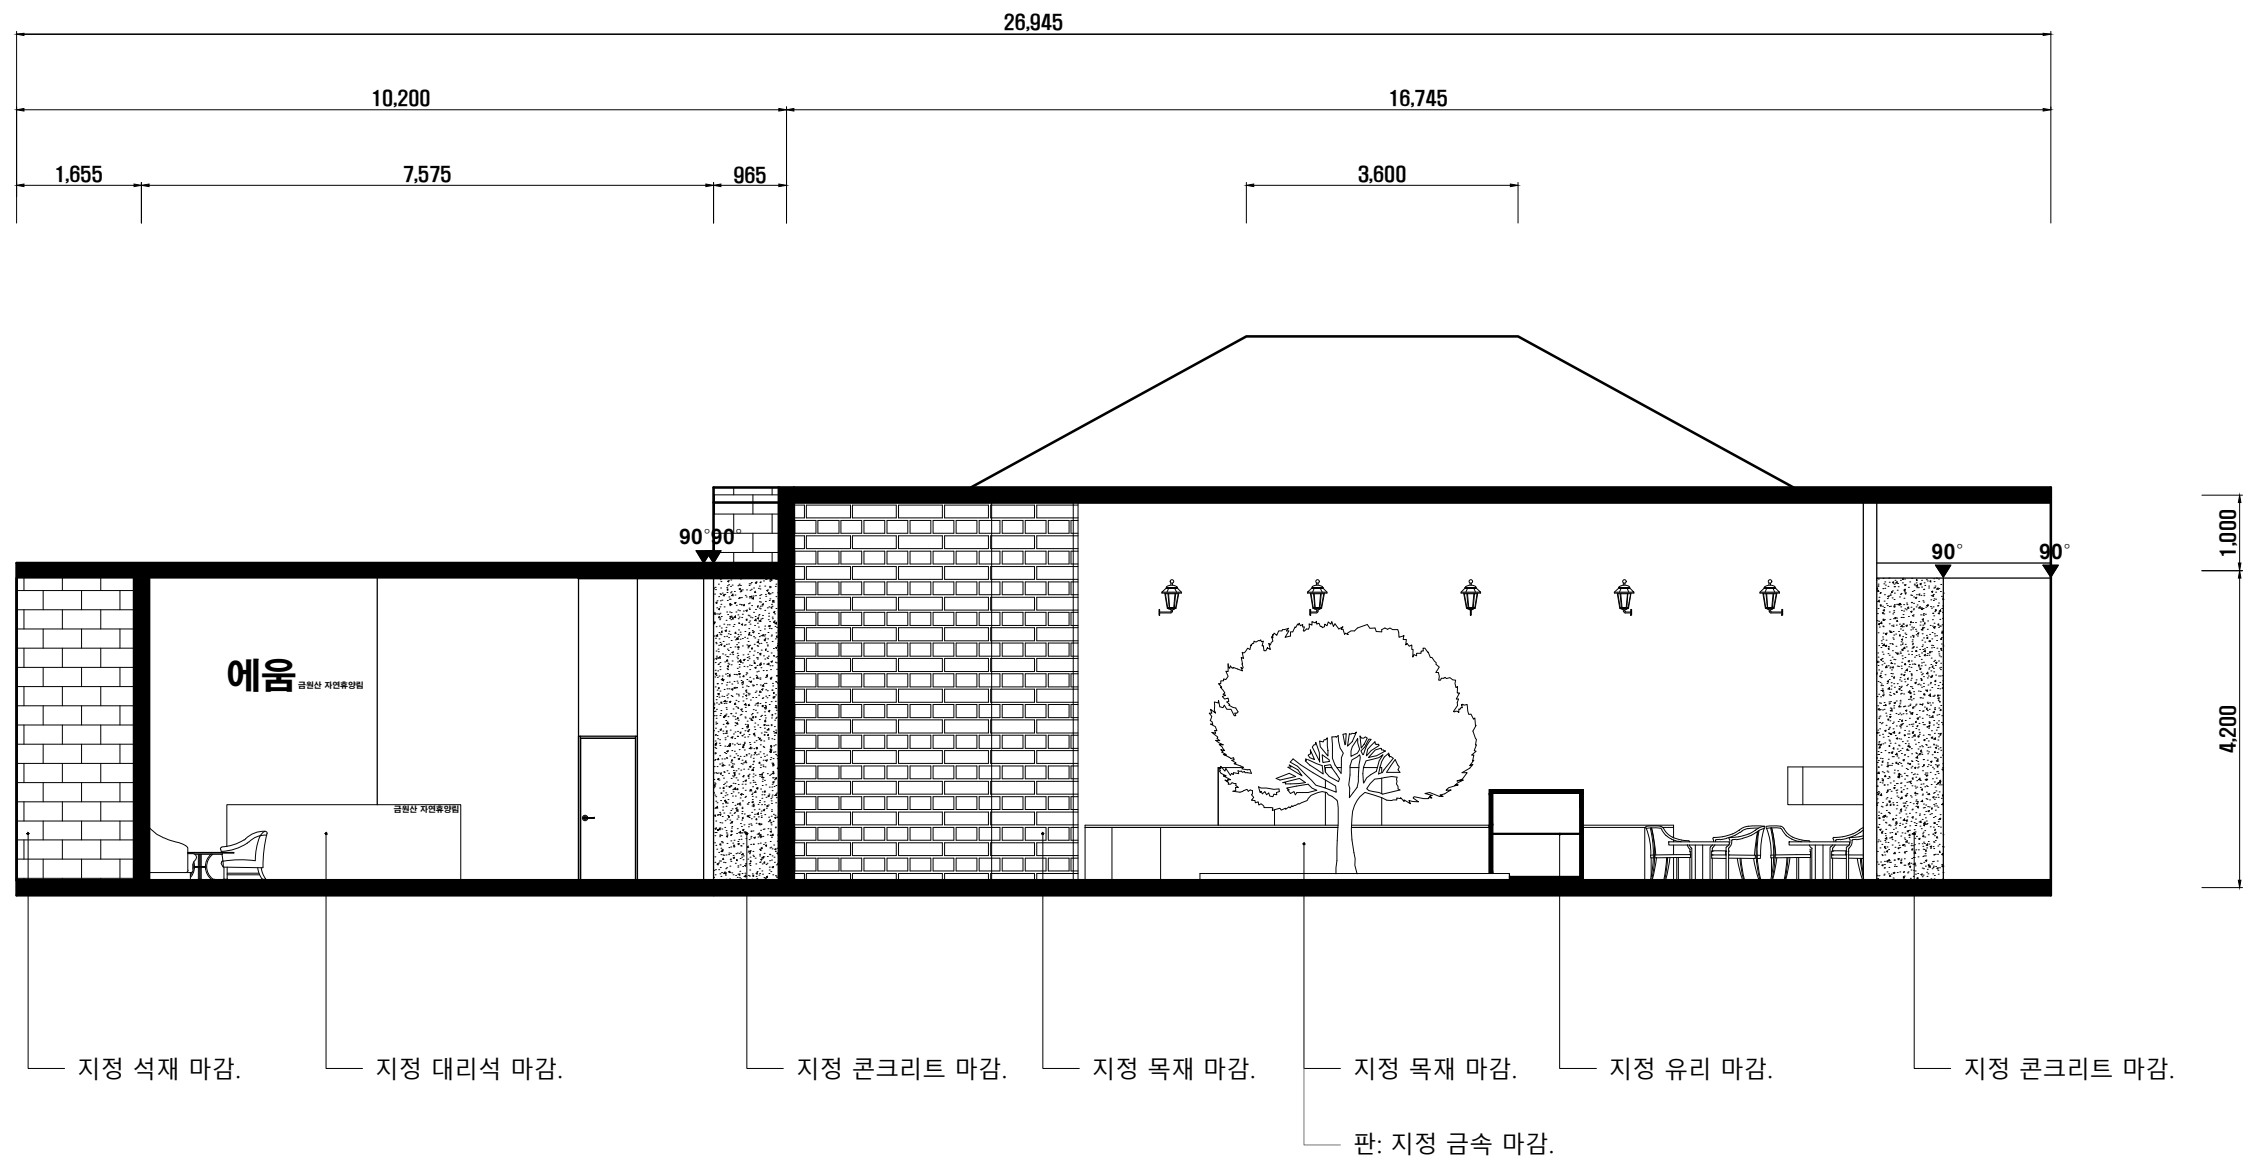

PROJECT TITLE

금원산 자연휴양림

DRAWING TITLE

LOBBY SECTION PLAN

SCALE

A1: 1/250 A3: 1/500

DATE

2021.10.16

APPROVED

201761709 박성희

201761728 허성은

DRAWING NO.

4

LIGHTING

SYMBOL	DESCRIPTION
	LED Light
+	Down Light
	Halogen Spot
	Pendant 1
	Pendant 2
	Pendant 3
	Pendant 4

PROJECT TITLE

금원산 자연휴양림

DRAWING TITLE

LOBBY CEILING PLAN

SCALE

A1: 1/150 A3: 1/300

DATE

2021.10.16


APPROVED



201761709 박성희

201761728 허성은

DRAWING NO.

5

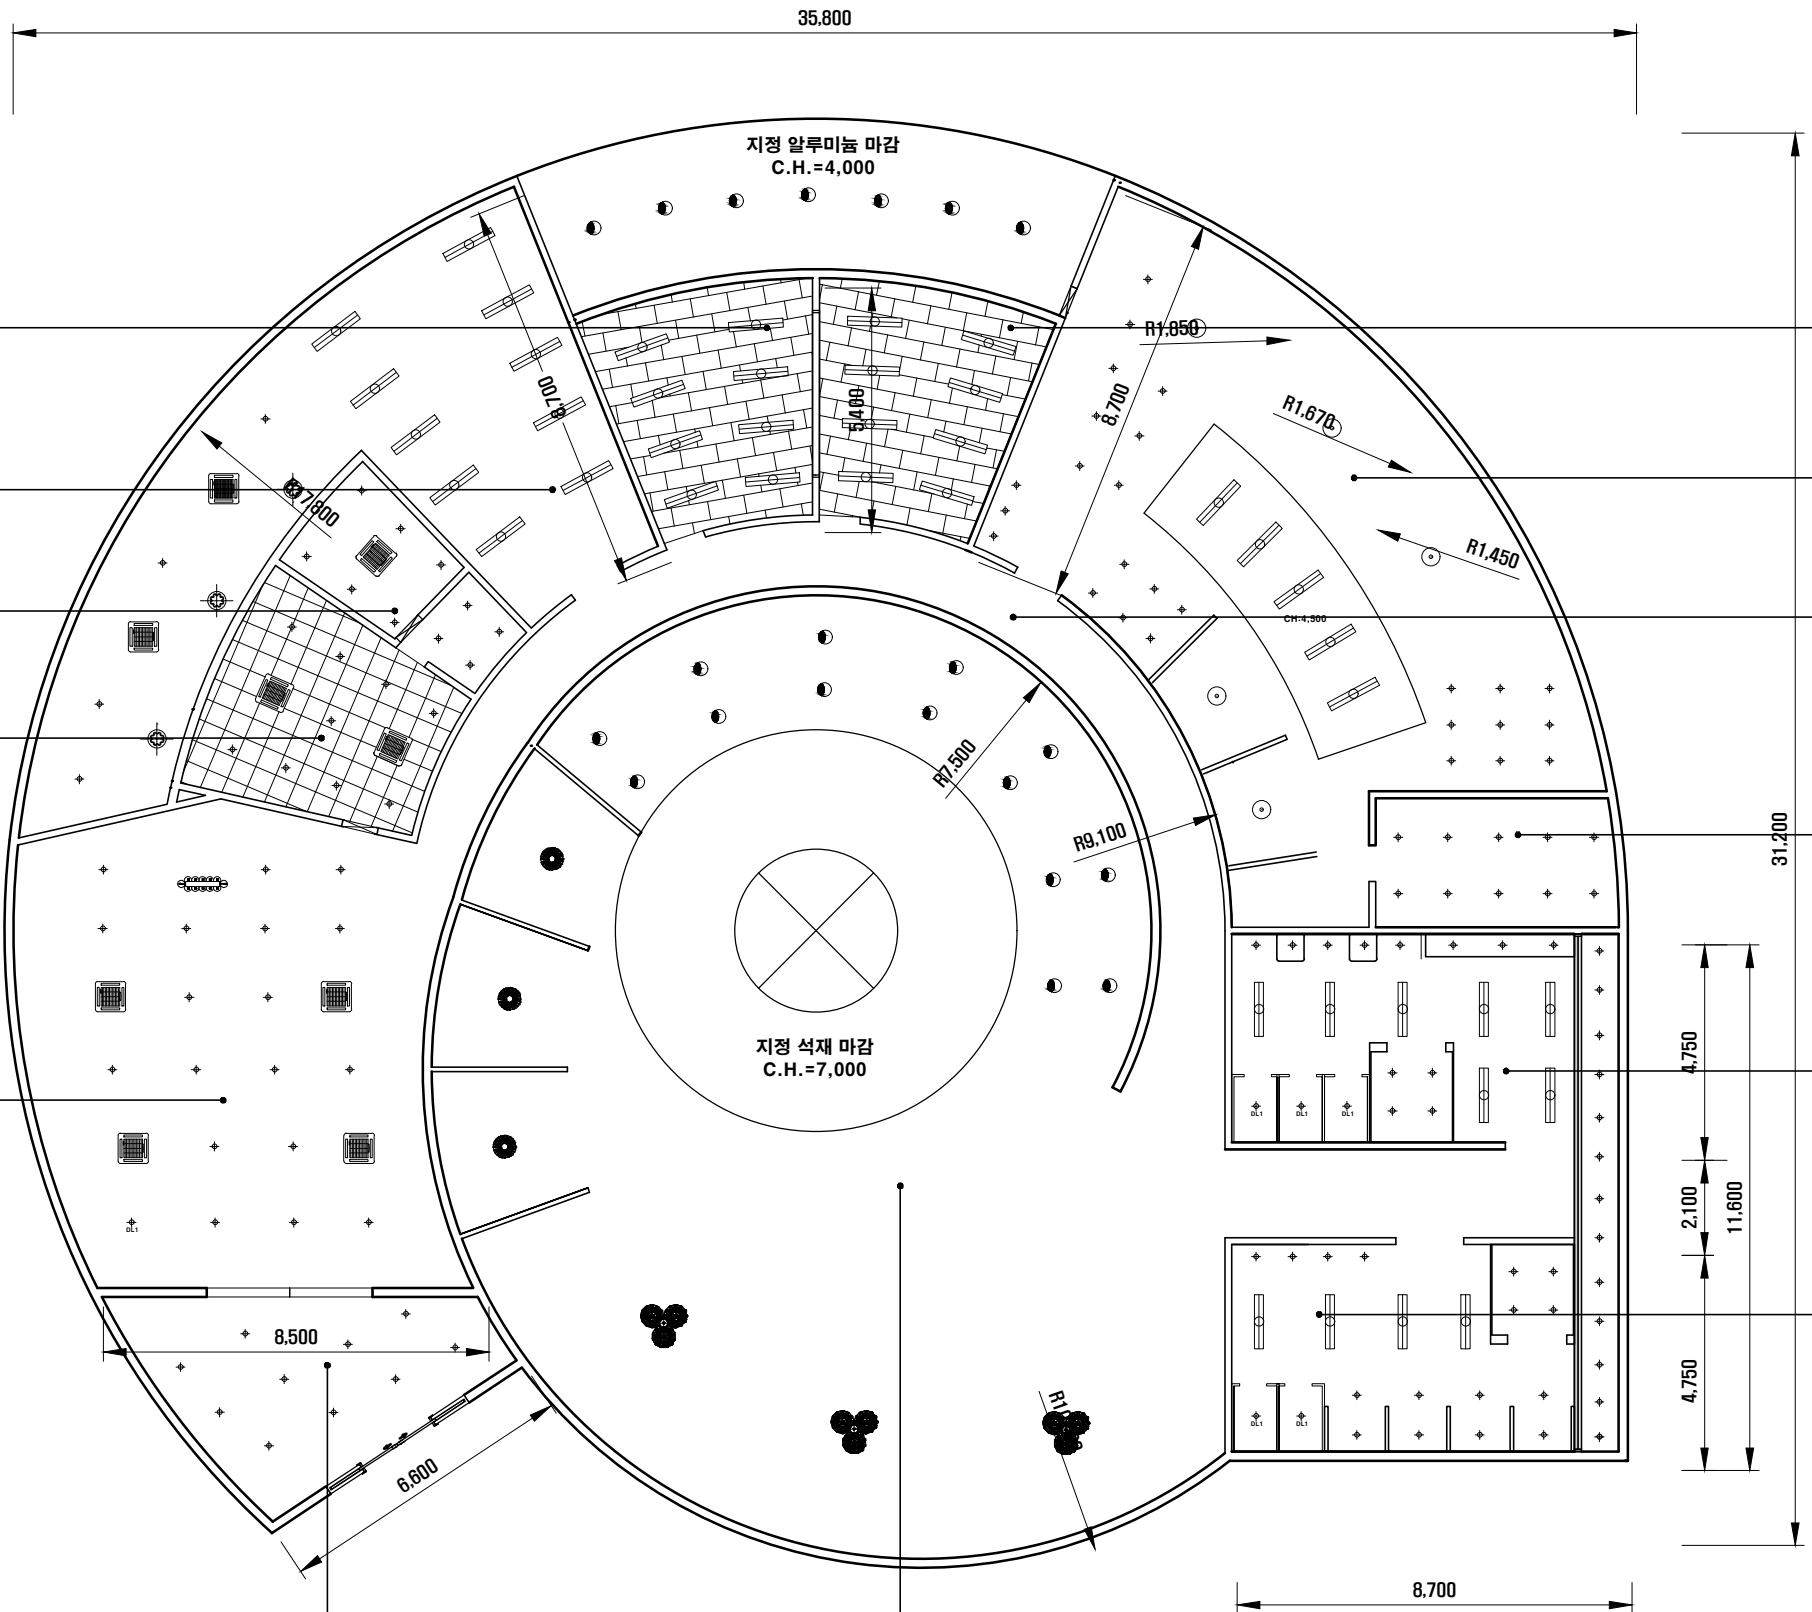

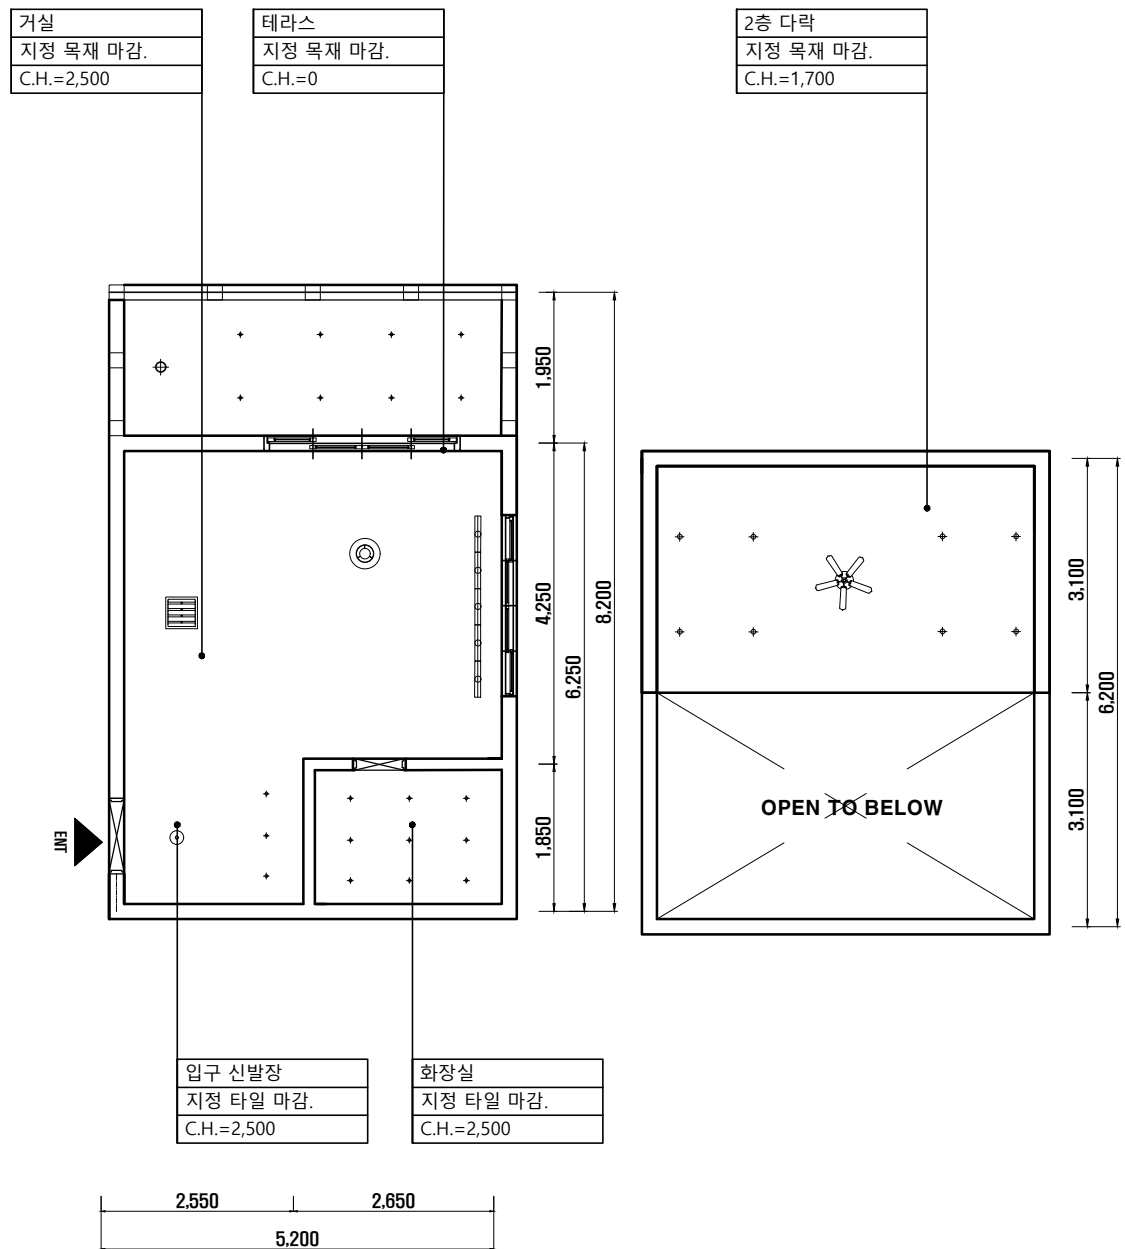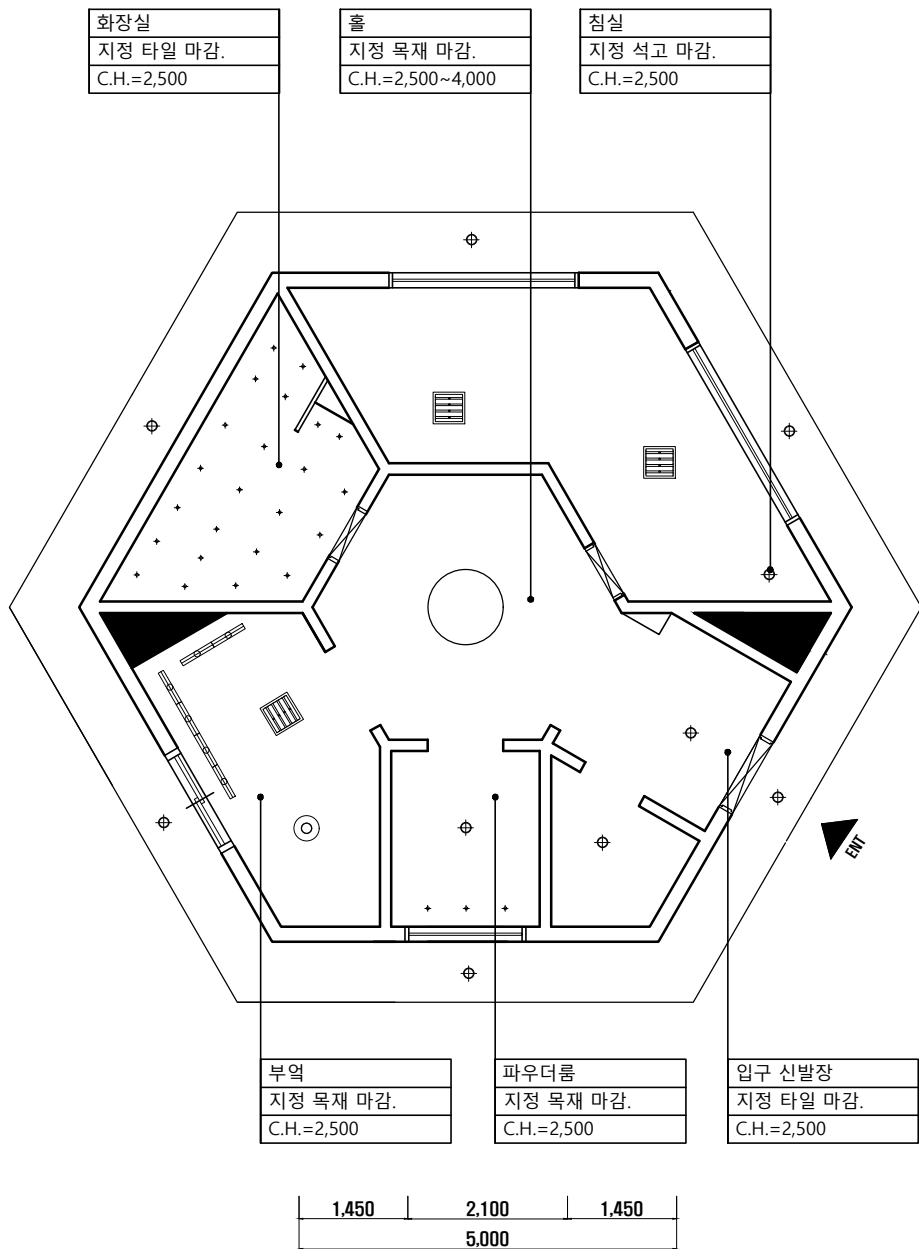

LIGHTING	
SYMBOL	DESCRIPTION
	LED Light 1
	LED Light 2
	Sensor Light
	Pendant 1
	Pendant 2

PROJECT TITLE
금원산 자연휴양림


DRAWING TITLE
2, 4인실 CEILING PLAN

SCALE
A1: 1/250 A3: 1/500

DATE
2021.10.16

APPROVED
201761709 박성희
201761728 허성은

DRAWING NO.
6

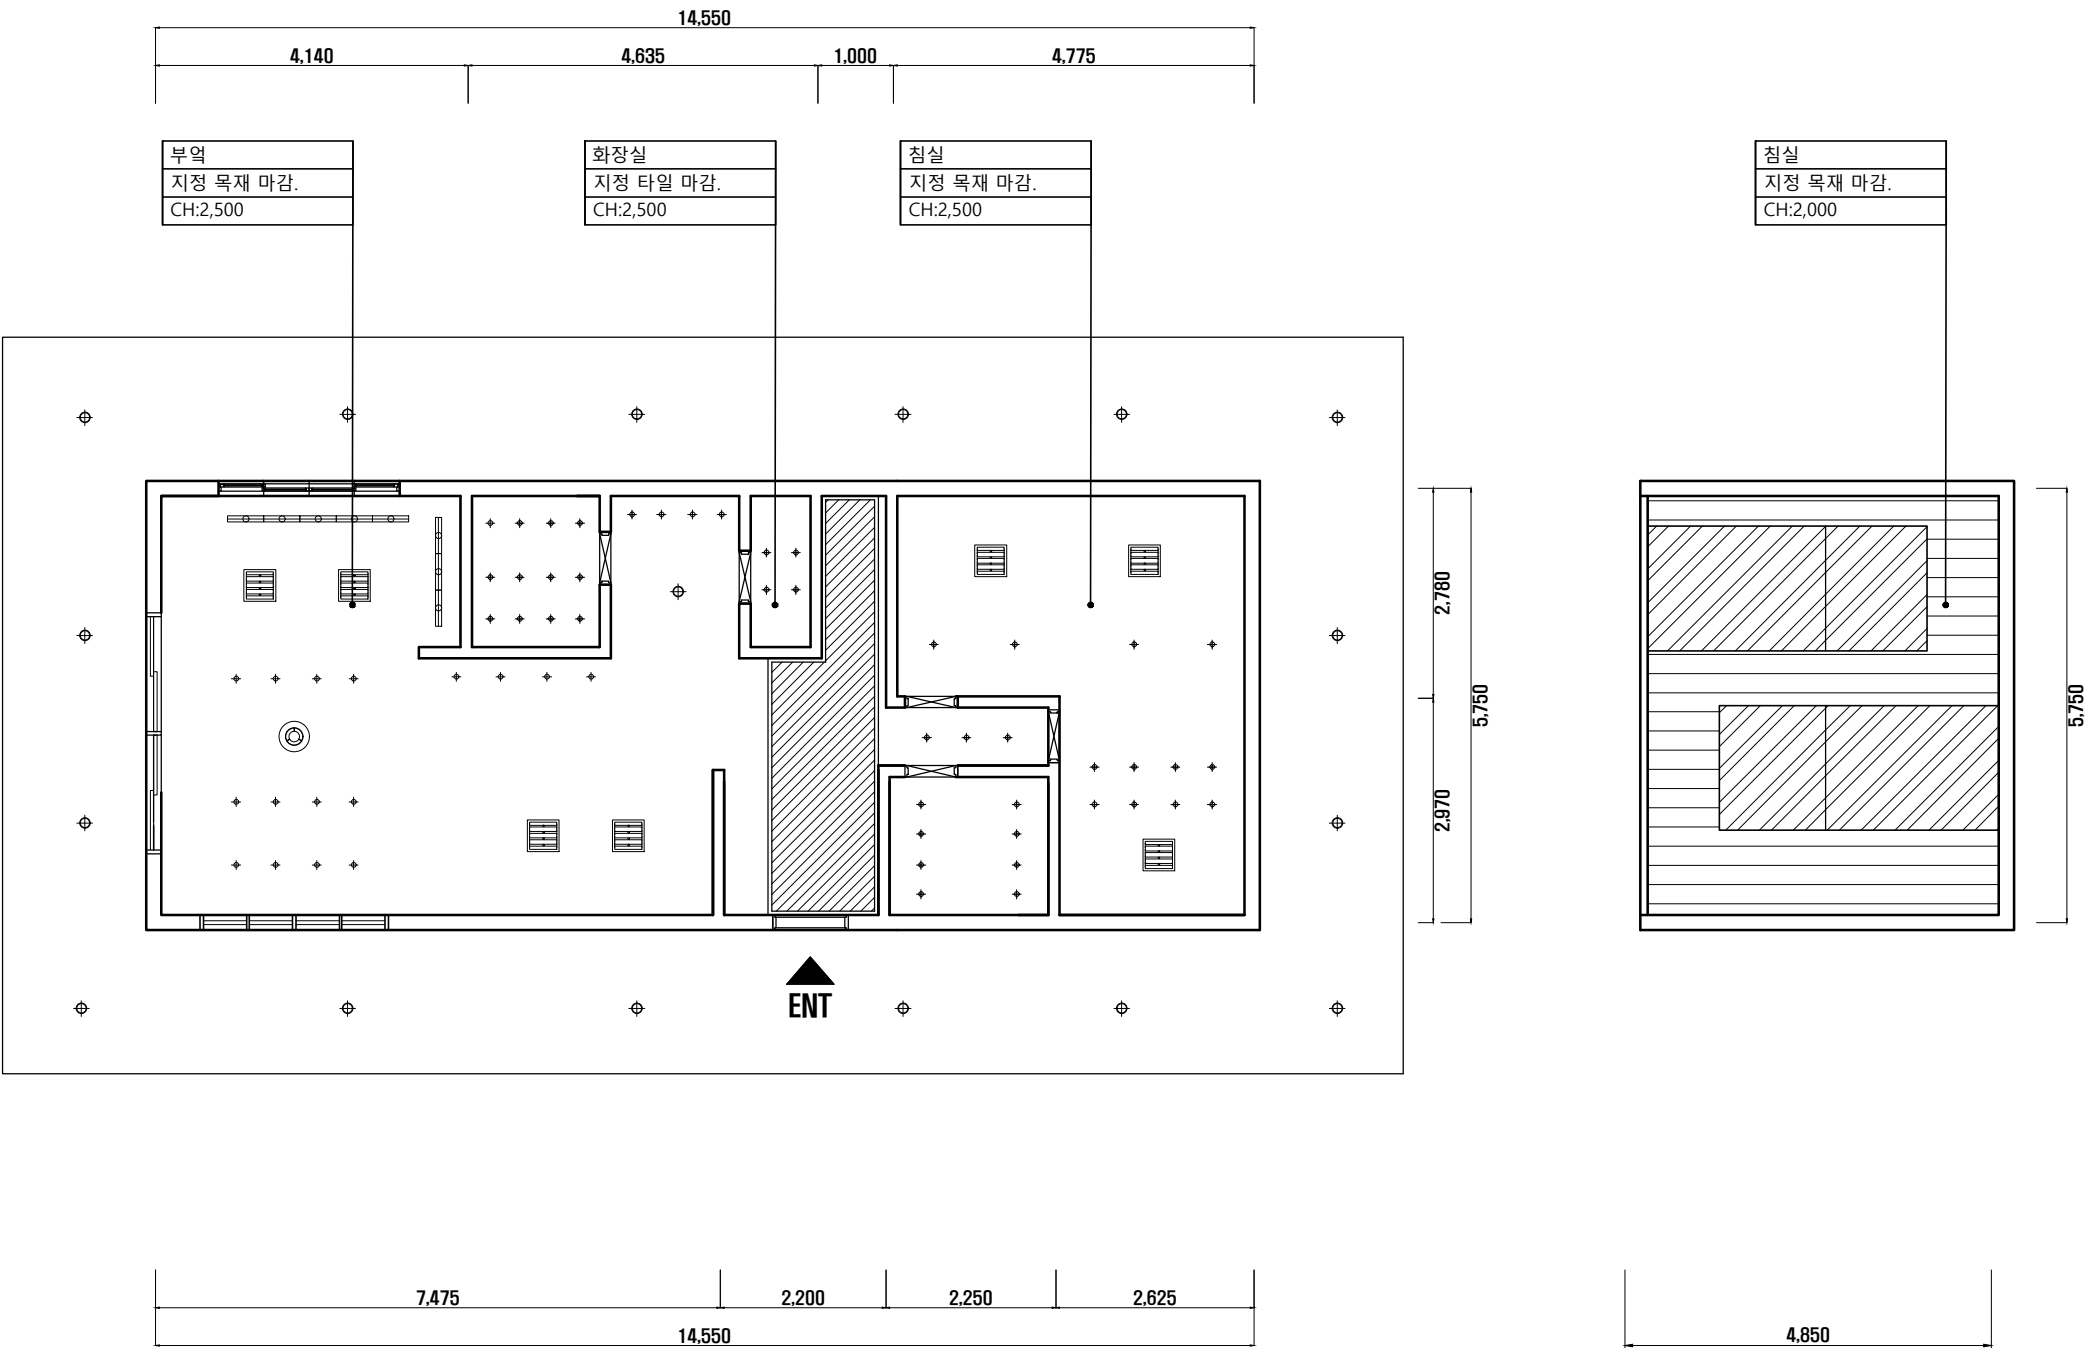

LIGHTING	
SYMBOL	DESCRIPTION
	LED Light 1
	LED Light 2
	Sensor Light
	Pendant 1
	Pendant 2

PROJECT TITLE
금원산 자연휴양림

DRAWING TITLE
8인실 CEILING PLAN

SCALE
A1: 1/250 A3: 1/500

DATE
2021.10.16

APPROVED
201761709 박성희
201761728 허성은

DRAWING NO.